JUNE 2011 NORTH ROAD SEWER PROJECT UPDATE

Spazzarini Construction has installed 1,010 feet of 15 inch gravity sewer as of Thursday afternoon June 16th.

Construction is now out of the roadway and pipe is being laid in the gutterline.

Five more Sanitary Manholes were installed; these being SMH 14 through SMH 18.

A difficult Storm Water Culvert Crossing was completed.

Two sanitary Wye connections were installed for future sewer laterals.

Although very wet conditions were expected, the clay is holding back the water and allowing the project to proceed at a relatively good pace.

Town of East Windsor WPCF
June 23, 2011

2011 East Windsor North Road Sewer Project Progress

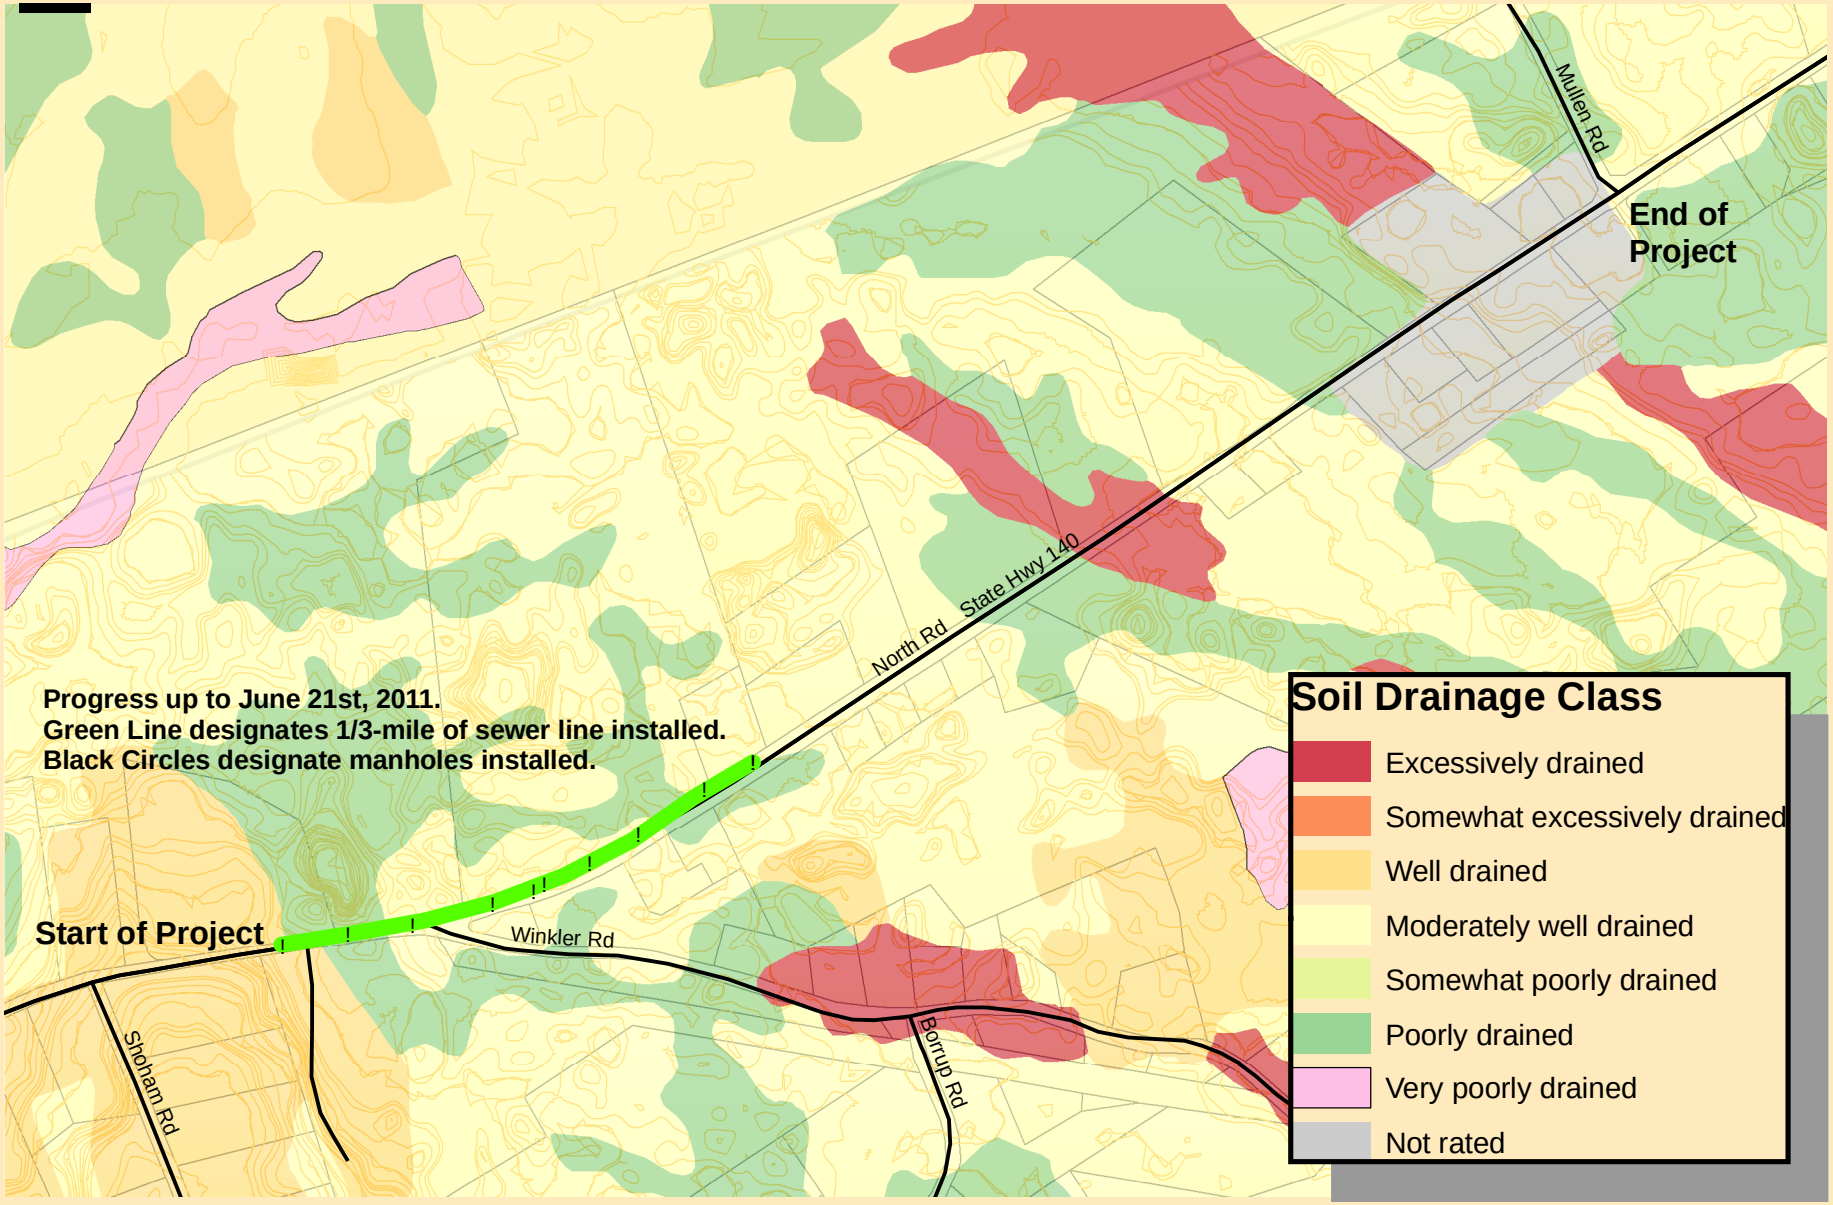

0.1 0 0.4 Miles